

VIEW OF ALLEY


EXISTING PARKING AREA

A R	СНІТЕСТ
40 Pearl S	Street t: 617.547 ge MA 02139 f: 617.547
	rankshirleyarchitects.c
PROJECT	
	Alterations to:
55	COMMONWEALTH AVE.
	Boston, MA 02116
EXISTING CONDITION OF THE GENERAL CONTROL OF THE CO	PLANS AND/OR PHOTOGRAPHS ARE A REPRESENTATION OF THE TITIONS OF THE BUILDING. THESE DRAWINGS/PHOTOGRAPHS AB HARACTERISTICS OF THE EXISTING CONDITIONS AND NOT AN DESTIGATION NOT ACTUAL HIDDEN CONDITIONS. THIS INFOR
FOR COORDINAT THE ARCHITECT	ION OF THE WORK TO BE PREFORMED BY THE GENERAL CONT BEARS NO RESPONSIBILITY FOR THE ACCURACY OF THIS INFO ONTRACTOR SHALL EXAMINE THESE CONDITIONS IN THE FIELD AND BECOME FAMILIAR WITH THE WORK. AFTER EXAMINATI THONS, THE GENERAL CONTRACTOR SHALL VERIFY ALL COND
FOR COORDINAT THE ARCHITECT	ION OF THE WORK TO BE PREPORATED BY THE CRESSEAL COM- TON OF THE WORK TO BE PREPORATED BY THE CRESSEAL COM- TON THE PREPARATE OF THE PREPARATE OF THE PREPARATE OF THE PREPARATE OF THE PREPARATE SET OF THE PREPARATE OF THE PREP
FOR COORDINAT THE ARCHITECT	BIAS OF THE WORK TO BE PREFUNDED BY THE GAINMAL CONT DOWNLOAD SECRET AND SECR
FOR COORDINAT THE ARCHITECT THE GENERAL O CONSTRUCTION EXISTING CONDI AND DIMENSION EXISTING CONDI PRIOR TO NOTIFI PLANS AND DIME	ISMO OF THE WORK TO BE PRICEWARD BY THE GENERAL CONT FOR THE PRICEWARD PRICEWARD PRICEWARD SENT THE PRICEWARD STREAMS THE PRICEWARD PRICEWARD PRICEWARD SENT THE PRICEWARD THOSE HER GENERAL CONTRACTOR SHALL YERRY ALL CONTRACTORS AND THE PRICEWARD
FOR COORDINAT THE ARCHITECT THE GENERAL C CONSTRUCTION EXISTING CONDI EXIST	
FOR COORDINAT THE ARCHITECT THE GENERAL C CONSTRUCTION EXISTING CONDI EXIST	AND BELONGE AMELIAN WITH THE WORK. AFTER EXAMINATION AND RECORD AND AND AND AND AND AND AND AND AND AN
FOR COORDINAT THE ARCHITECT THE GENERAL C CONSTRUCTION EXISTING CONDI EXIST	AND BELONGE AMELIAN WITH THE WORK. AFTER EXAMINATION AND RECORD AND AND AND AND AND AND AND AND AND AN
FOR COORDINAT THE ARCHITECT THE GENERAL C CONSTRUCTION EXISTING CONDI EXIST	AND BELOOME AMELIAN WITH THE WORK. AFTER EXAMINATION AND RECORD AND AND AND AND AND AND AND AND AND AN
FOR COMBINAT FOR COMBINAT FINE GISHBAL CONSTILLETION FOR CONSTILLE	AND BECOME FAMILIA WITH THE WORK. AFTER EXAMINATE AND NOTIFY THE AUGUST OF ANY DESCRIPTION OF A STREET
FOR COMBINAT FOR COMBINAT FINE GISHRAT CONSTITUTION FOR CONTRACT CONSTITUTION FOR CONTRACT CONSTITUTION FOR CONTRACT CON	ASD BECOME FAMILIAN WITH THE WORK. AFTER EXAMINATION AND ADMINISTRATION AND THE WORK AND THE THE WORK AND THE THE WORK AND THE WORK FROM THE WORK AND THE WORK FROM THE WORK AND THE WORK FROM THE WORK AND THE WORK
FOR COMBINAT FOR COMBINAT FINE GISHRAT CONSTITUTION FOR CONTRACT CONSTITUTION FOR CONTRACT CONSTITUTION FOR CONTRACT CON	ASD BECOME FAMILIAN WITH THE WORK. AFTER EXAMINATION AND ADMINISTRATION AND THE WORK AFTER EXAMINATION AND THE MEN PROPOSED WORK. ALL WORK CONSTRUCTIONS AND THE MEN PROPOSED WORK. ALL WORK CONSTRUCTIONS AND THE MEN PROPOSED WORK. ALL WORK CONSTRUCTIONS AND THE WORK ALL WORK CONSTRUCTION AND THE WORK ALL WORK CONTRACTOR AND THE WORK A
FOR COMBINAT FOR COMBINAT FINE GISHRAT CONSTITUTION FOR CONTRACT CONSTITUTION FOR CONTRACT CONSTITUTION FOR CONTRACT CON	ASD BECOME FAMILIAN WITH THE WORK. AFTER EAAMINATE AS AND NOTIFY THE ACCURATION OF THE MEN PROPOSED WORK. ALL WORK CONSTRUCT DISSIONS AND THE NEW PROPOSED WORK. ALL WORK CONSTRUCT DISSIONS SHALL BE REPLACED BY THE GENERAL CONTRACTOR BEAC REVIEW SHIRLEY ARCHITECTS, 2017. All rights res ng cannot be reproduced without permission.

April 12, 2017

BBAC-1

SHEET NUMBER

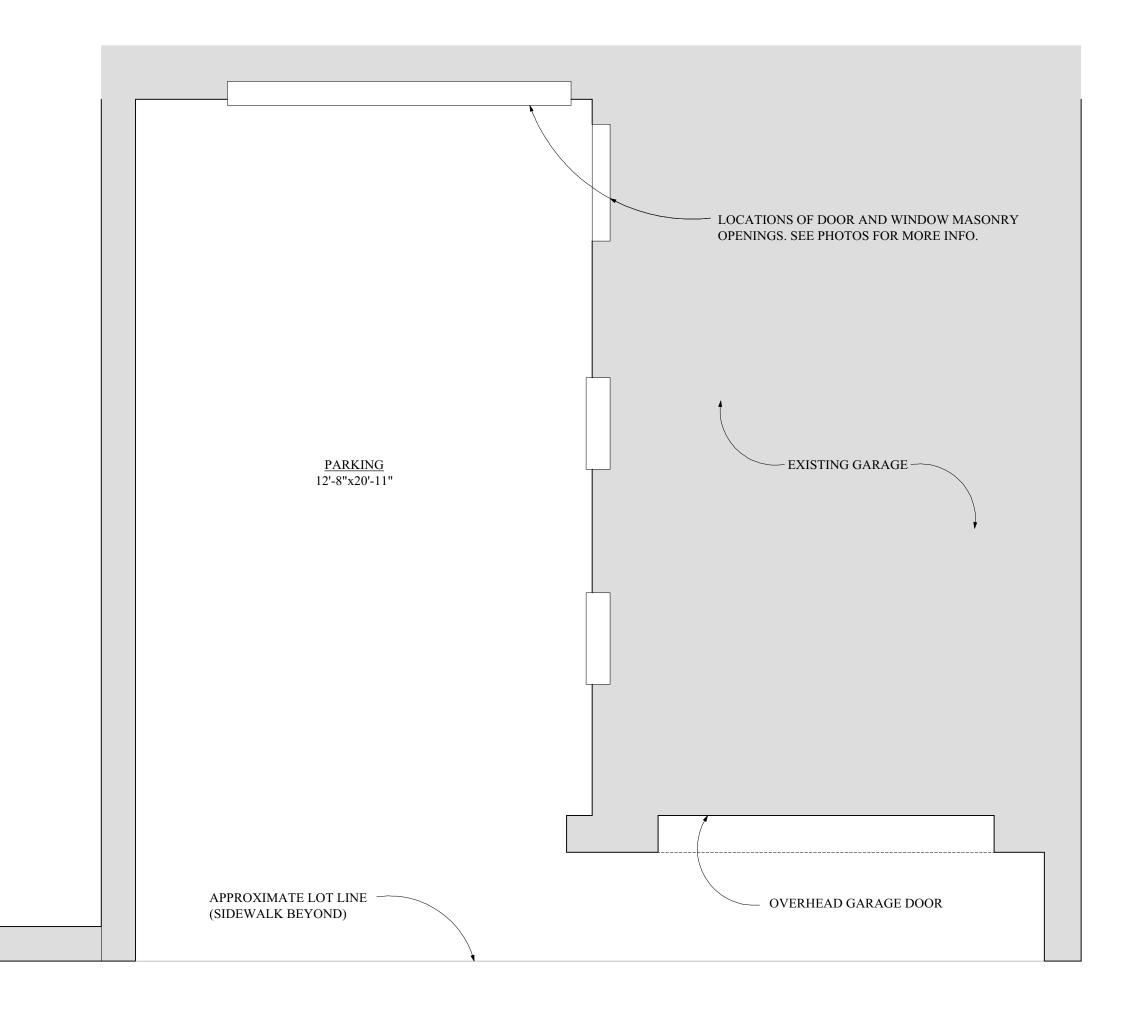

AS-BUILT PLAN

A R C H	I T E C T
40 Pearl Street Cambridge MA 0213	t: 617.547.33 39 f: 617.547.23
www.frankshi	rleyarchitects.com
PROJECT	
Alte	erations to:
FF COMM	ONIVA/FALTILIAN/F
	ONWEALTH AVE. n, MA 02116
THESE EXISTING PLANS AND/OR PHO	OTOGRAPHS ARE A REPRESENTATION OF THE
EXISTING CONDITIONS OF THE BUILD THE GENERAL CHARACTERISTICS OF EXHAUSTIVE INVESTIGATION INTO	DING. THESE DRAWINGSPHOTOGRAPHS ARE FC F THE EXISTING CONDITIONS AND NOT AN ACTUAL HIDDEN CONDITIONS. THIS INFORMATI TO BE PREFORMED BY THE GENERAL CONTRACT SIBILITY FOR THE ACCURACY OF THIS INFORMAT EXAMINE THESE CONDITIONS IN THE FIELD PRI
THE ARCHITECT BEARS NO RESPONS THE GENERAL CONTRACTOR SHALL CONSTRUCTION AND BECOME FAMIL EXISTING CONDITIONS, THE GENERA AND DIMENSIONS AND NOTIFY THE .	IBILITY FOR THE ACCURACY OF THIS INFORMA EXAMINE THESE CONDITIONS IN THE FIELD PRI LIAR WITH THE WORK. AFTER EXAMINATION O AL CONTRACTOR SHALL VERIFY ALL CONDITION ARCHITECT OF ANY DISCREPANCIES BETWEEN
EXISTING CONDITIONS AND THE NEW PRIOR TO NOTIFICATION, THAT DOES PLANS AND DIMENSIONS SHALL BE I	EXAMINE THESE CONDITIONS IN THE FIELD PRI LLAR WITH THE WORK. AFFER EXAMINATION O AL CONTRACTOR SHALL VERHY ALL CONDITION ARCHITECT OF ANY DISCREPANCIES BETWEEN W PROPOSED WORK. ALL WORK CONSTRUCTED S NOT CONFORM TO THE DESIGN OR LAYOUT OF REPLACED BY THE GENERAL CONTRACTOR.
ISSUES / REVISIONS	
Date Description 12 APR 17 BBAC RE	
	HITECTS, 2017. All rights reserv reproduced without permission.
DRAWING TITLE	

April 12, 2017

BBAC-2

SHEET NUMBER



AS-BUILT ELEVATION

FRANK SHIRLEY ARCHITECTS 40 Pearl Street Cambridge MA 02139 t: 617.547.3355 f: 617.547.2385 www.frankshirleyarchitects.com PROJECT Alterations to: 55 COMMONWEALTH AVE. Boston, MA 02116 ISSUES / REVISIONS Date Description 12 APR 17 BBAC REVIEW

© FRANK SHIRLEY ARCHITECTS, 2017. All rights reserved. This drawing cannot be reproduced without permission.

DRAWING TITLE

As-Built Elevation

SCALE

DATE

April 12, 2017

SHEET NUMBER






NEIGHBOR'S GATE @ ALLEY

FENCE AT FRONT OF PROPERTY

40 Pearl Street t: 617.5 Cambridge MA 02139 f: 617.5 www.frankshirleyarchitects Alterations to: 55 COMMONWEALTH AV Boston, MA 02116 THESE EXISTING GRANE ANDOR PROTOGRAPHS ARE A REPRESENTATION EXISTING CONDITIONS OF THE BUILDING. THESE BRAWNES-PROTOGRAPH EXISTED CONDITIONS OF THE BUILDING THE BURNES AND NO EXIST BURNES AND DESPONSIBILITY FOR THE ACCURACY OF THIS HE GARCHET BRANE NO RESPONSIBILITY FOR THE ACCURACY OF THE HE ACCURACY THAN THAT ONE ALL EXISTING CONDITIONS. THE GENERAL CONTRACTION SHALL EXISTING CONDITIONS. HE GARCHET BRANE NO RESPONSIBILITY FOR THE ACCURACY OF THE HE ACCURACY THAN THE ACCURACY THAN THE CONTRACTION SHALL EXIST OF THE DESCENDENT HE GARCHET BRANE NO RESPONSIBILITY FOR THE ACCURACY OF THE HE GARCHET BRANE OF THE SAME OF THE CONTROL OF THE HE GARCHET BRANE NO RESPONSIB	Cambridge MA 02139 f: 6 www.frankshirleyarchite Alterations to: 55 COMMONWEALTH Boston, MA 02116 THESE EXISTING PLANS ANDOR PHOTOGRAPHS ARE A REPRESENT EXISTING CONDITIONS OF THE BURE DIG. THESE DEARMORS FRO EXISTING CONDITIONS OF THE WORK TO BE PERFORMED BY THE GE EXISTING CONTRICTORS SHALL EXAMINE THISE CONDITIONS COORDINATION OF THE WORK TO BE PERFORMED BY THE GE EXISTING CONDITIONS OF THE WORK TO BE PERFORMED BY THE EXISTING CONDITIONS AND THE SHAW WITH THE WORK. AFTER AND DIMENSIONS AND NOTBY THE ARCHITECT OR ANY DESCRIPT EXISTING CONDITIONS AND THE SHAW WITH THE WORK. AFTER AND DIMENSIONS SHALL BE REPLACED BY THE GENERAL- OF PLANS AND D	A\\;
Cambridge MA 02139 f. 617.5 WWW.frankshirleyarchitects Alterations to: 55 COMMONWEALTH AV Boston, MA 02116 THESS ENSTING PLANS AND OR PROTOGRAPHS ARE A REPRESENTATION BUSING CONDITIONS OF THE BUELDING. THESE BLAWNEAS PROTOGRAPHS ENGLANDED THE WORLD FOR PROTOGRAPHS ARE A REPRESENTATION OF COORDINATION OF THE WORLD FOR PROTOGRAPHS AND REPRESENTED AND THE GENERAL CONTRACTOR SHALL EXAMINE HISSE CONDITIONS IN THE EGISERAL CONTRACTOR SHALL EXAMINE HISSE CONDITIONS IN THE EGISERAL CONTRACTOR SHALL EXAMINE HISSE CONDITIONS IN THE EGISTRAC CONTRACTOR SHALL EXAMINE HISSE CONDITIONS IN THE GENERAL CONTRACTOR AND DIMENSIONS AND INCIDING WHITE HE WAS AND DIMENSIONS SHALL BE REPLACED BY THE GINSIERAL CONTRA ISSUES / REVISIONS Date Description 12 APR 17 BBAC REVIEW © FRANK SHIRLEY ARCHITECTS, 2017. All rights OF FRANK SHIRLEY ARCHITECTS, 2017. All rights	Cambridge MA 02139 f: 6 www.frankshirleyarchite Alterations to: 55 COMMONWEALTH Boston, MA 02116 THESE EXISTING PLANS ANDOR PHOTOGRAPHS ARE A REPRESENT EXISTING CONDITIONS OF THE BURE DIG. THESE DEARMORS FRO EXISTING CONDITIONS OF THE WORK TO BE PERFORMED BY THE GE EXISTING CONTRICTORS SHALL EXAMINE THISE CONDITIONS COORDINATION OF THE WORK TO BE PERFORMED BY THE GE EXISTING CONDITIONS OF THE WORK TO BE PERFORMED BY THE EXISTING CONDITIONS AND THE SHAW WITH THE WORK. AFTER AND DIMENSIONS AND NOTBY THE ARCHITECT OR ANY DESCRIPT EXISTING CONDITIONS AND THE SHAW WITH THE WORK. AFTER AND DIMENSIONS SHALL BE REPLACED BY THE GENERAL- OF PLANS AND D	A\\;
Alterations to: 55 COMMONWEALTH AV Boston, MA 02116 THESE EXECTS FLASS AND REPROPOGRAPIS ARE A REPRESENTATION AND THE GASHAGE, CHARLACTERISTICS OF THE EXECUTION CONTROL OF THE BURNING CONDITIONS AND NO EMULASTIVE INVESTIGATION INTO ACTUAL HIDDING CONDITIONS AND NO EMULASTIVE INVESTIGATION INTO ACTUAL HIDDING CONDITIONS IN THE GASHERIC CHARLACTERISTICS OF THE EXEMPTION CONTROL OF THE THE GASHERIC CHARLACT OF THE THE GASHERIC CHARLACT OF THE CARCHITECT HAS NO RESPONSIBLE WITH THE WORK CAN AND DIMENSIONS AND NOTIFY THE ARCHITECT OF ANY DISCRIPTANCES AND DIMENSIONS AND NOTIFY THE ARCHITECT OF ANY DISCRIPTANCES AND DIMENSIONS AND NOTIFY THE ARCHITECT OF ANY DISCRIPTANCES AND DIMENSIONS AND NOTIFY THE ARCHITECT OF ANY DISCRIPTANCES AND DIMENSIONS AND NOTIFY THE ARCHITECT OF ANY DISCRIPTANCES AND DIMENSIONS SHALL BE REPLACED BY THE GINERAL CONTROL OF THE ARCHITECT OF ANY DISCRIPTANCES AND DIMENSIONS SHALL BE REPLACED BY THE GINERAL CONTROL OF THE ARCHITECT OF ANY DISCRIPTANCES. ISSUES / REVISIONS Date Description 12 APR 17 BBAC REVIEW © FRANK SHIRLEY ARCHITECTS, 2017. All rights	Alterations to: 55 COMMONWEALTH Boston, MA 021116 THESE EXISTING FLANS AND SE PROTOGRAPHS ARE A REPRESENT THESE EXISTING FLANS AND SE PROTOGRAPHS ARE A REPRESENT THE CONTROL CONTROL OF THE RESISTING CONDITIONS. EXILALITY INVESTIGATION INTO ACTUAL HIDDOS CONDITIONS. EXILALITY INTO ACTUAL HIDDOS CONDITIONS. EXILALITY INTO ACTUAL HIDDOS CONDITIONS. EXILALITY INTO ACTUAL HIDDOS CONDITIONS. INTO ACTUAL HIDDOS CONDITI	۸۱,
Alterations to: 555 COMMONWEALTH AV Boston, MA 021116 THESE EXISTING PLANS ANDOR PROTOGRAPIS ARE A REPRESENTATION OF SENSING CONDITIONS OF THE BUILDING. THESE DRAWNAS PROTOGRAPIS ARE A SEPRESENTATION OF SENSING CONDITIONS OF THE BUILDING THESE DRAWNAS PROTOGRAPIS AND THE CONTRACTOR SINGLE PROTOGRAPIS AND THE CONSTRUCTION OF THE WORK TO BE REPRESENDED WITH ELECTROPIC AND THE CONSTRUCTION SINGLE PROTOGRAPIS AND THE CONSTRUCTION AND TH	Alterations to: 555 COMMONWEALTH BOSTON, MA 021116 THESE EXISTING PLANS ANDOR PHOTOGRAPHS ARE A REPRESENT EXISTING CONDITIONS OF THE BURLING. THESE DRAWNGSPHO EXISTING CONDITIONS OF THE WORK TO BE REFORMED BY THE GE EXISTING CONDITIONS OF THE WORK TO BE REFORMED BY THE GE EXISTING CONDITIONS THE WORK TO BE REFORMED BY THE GE EXISTING CONDITIONS THE GOVERN WITH THE WORK. AFTE EXISTING CONDITIONS AND THE SINK TO REVORED WORK. ALL WO PRODE TO NOTIFICATION THAT DOES NOT COMPANY TO THE DAY THE GENERAL CONTRACTOR SHALL BE REPLACED BY THE GENERAL SISTING CONDITIONS AND THE SINK TO REVORED WORK. SISSUES / REVISIONS Date Description 12 APR 17 BBAC REVIEW © FRANK SHIRLEY ARCHITECTS, 2017. All	
THESE EXISTING PLANS AND OR PROTOGRAPHIS ABE, A REPRESENTATION EXISTING CONDITIONS OF THE BRILLIONS. THE SENDING CONDITIONS AND THE GENERAL CHARACTERITIES OF THE EXERTING CONDITIONS AND THE GENERAL CHARACTERITIES OF THE EXERTING CONDITIONS IN THE EXERCITION OF THE ACCURACY OF THE EXERTING CONDITIONS IN THE EXERCITIC OF THE ACCURACY OF THE EXERTING CONDITIONS IN THE EXERCITIC OF THE ACCURACY OF THE EXERTING CONDITIONS IN THE EXERT CONDITIONS IN	THESE EXISTING PLANS AND/OR PROTOGRAPHS ABE A REPRESENT EXISTING CONDITIONS OF THE HURLIDING. THESE DRAWNGS PROTOGRAPHS ABE A REPRESENT EXISTING CONDITIONS OF THE HURLIDING. THE EXEMPTION CONDITIONS THE GENERAL CONDITIONS THE HURLIDING CONDITIONS CONDITIONS THE GENERAL CONTRACTOR SHALL YER GENERAL CONTRACTOR SHALL YER GENERAL CONTRACTOR SHALL YER GENERAL CONTRACTOR SHALL YER PROPERTY OF THE ACCURACY OF THE ACCU	
BOSTON, MA 021116 THESSE EXISTING PLANS AND/OR PHOTOGRAPHS ARE A REPRESENTATION EXISTING CONDITIONS OF THE BUILDING. THISSI DRAWNGS-PHOTOGRAPH CONDITIONS OF THE WORK TO BE REPRESENDED THE BUILDING CONDITIONS OF THE WORK TO BE REPRESENDED THE BUILDING CONDITIONS IN THE CONTRICTION SHOWN AND THE WORK TO BE REPRESENDED AND THE SECONDARY THE EXPERIMANT OF THE WORK TO ANY DISCREPANCESS THE SECONDARY OF THE WORK TO ANY DISCREPANCESS IN SECONDARY OF THE WORK TO ANY DISCREPANCESS. ISSUES / REVISIONS Date Description 12 APR 17 BBAC REVIEW © FRANK SHIRLEY ARCHITECTS, 2017. All rights	BOSTON, MA 021116 THESE EXISTING PLANS AND/OR PHOTOGRAPHS ARE A REPRESENT EXISTING CONDITIONS OF THE BIRLIDM. THESE DRAWNGS-PRO- EXHAUSTRY INVESTIGATION INTO ACTUAL HIDDOST CONDITIONS EXHAUSTRY INVESTIGATION INTO ACTUAL HIDDOST CONDITIONS CONDITIONS OF THE WORK TO BE REPROMAD BY THE GE- THE CONDEAL CONTRACTOR SHALL EXAMINE THISE CONDITIONS CONSTRUCTION AND RECOME FAMILE WITH THE WORK. AFTER AND DIMENSIONS AND NOTITY THE ARCHITECT OF ANY DESCRIPT EXISTING CONDITIONS AND THE THE WORK OF THE CONTRACTOR PLANS AND DIMENSIONS SHALL BE REPLACED BY THE GENERAL- ISSUES / REVISIONS Date Description 12 APR 17 BBAC REVIEW © FRANK SHIRLEY ARCHITECTS, 2017. All	
BOSTON, MA 021116 THESE EXISTING PLANS AND/OR PHOTOGRAPHS ARE A REPRESENTATION EXISTING/CONDITIONS OF THE BULLDAG. THISE DRAWNAGS/HOTOGRAPH CONDITIONS OF THE WORK TO BE REPRESENDED THE EXPRESENTATION OF COORDINATION OF THE WORK TO BE REPRESENDED THE EXPRESAL CONTRACTOR SHALL EXAMINE HISES CONSITIONS IN THE CONSTRUCTION AND THE EXPRESAL AND DIMENSIONS AND INJUTY THE ARCHITECT OF ANY DISCREPANCIES IN THE CONSTRUCTION AND THE WORK ON PRAISE EXAMINE CONSTRUCTION AND THE WORK ON PRAISE EXAMINE CONTRACTOR SHALL PROSECUTED THE CONTRACTOR SHALL EXAMINE CONTRACTOR SHALL EXAMINE THE EXAMINATION OF THE WORK ON PRAISE EXAMINE CONTRACTOR SHALL PROSECUTED AND THE CONTRACTOR SHALL EXAMINE THE EXAMINATION OF THE WORK ON PRAISE EXAMINATION AND THE SHAPE PROSECUTED THE CONTRACTOR SHALL PROVIDED THE CONTRACTOR OF THE CONTRACTOR	BOSTON, MA 021116 THESE EXISTING PLANS AND/OR PHOTOGRAPHS ARE A REPRESENT EXISTING CONDITIONS OF THE BIRLIDM. THESE DRAWNGS-PRO- EXHAUSTRY INVESTIGATION INTO ACTUAL HIDDOST CONDITIONS EXHAUSTRY INVESTIGATION INTO ACTUAL HIDDOST CONDITIONS CONDITIONS OF THE WORK TO BE REPROMAD BY THE GE- THE CONDEAL CONTRACTOR SHALL EXAMINE THISE CONDITIONS CONSTRUCTION AND RECOME FAMILE WITH THE WORK. AFTER AND DIMENSIONS AND NOTITY THE ARCHITECT OF ANY DESCRIPT EXISTING CONDITIONS AND THE THE WORK OF THE CONTRACTOR PLANS AND DIMENSIONS SHALL BE REPLACED BY THE GENERAL- ISSUES / REVISIONS Date Description 12 APR 17 BBAC REVIEW © FRANK SHIRLEY ARCHITECTS, 2017. All	
THESE EXISTING PLANS AND IVE PROTOGRAPHS ARE A REPRESENTATION ENSURING CONSTRUME OF THE RELIGIONG. THESE DRAWNGS-PROTOGRAPH CONSTRUCTIONS OF THE RELIGIONG. THESE DRAWNGS-PROTOGRAPH CONSTRUCTION OF THE EXISTING CONDITIONS AND NO EMULASTIVE INVESTIGATION INTO ACTUAL HIDDIN CONSTRUMEN IS THE CONSTRUCTION OF THE ACCURRIC HEARD NO RESINOSHIP IN TO RETHE ACCURACY OF THIS THE CONSTRUCTION OF THE ACCURRIC HEARD NO RESINOSHIP IN THE RECEIVED OF THE CONSTRUCTION OF THE ACCURRIC HEARD NO RESINOSHIP IN THE ACCURRIC OF THE ACCURRIC HEARD NO RESINOSHIP IN THE ACCURRIC AND DIMENSIONS AND NOTIFY THE ACCURRIC OF THE OWNER OF THE ACCURRIC HEARD NOTICE OF THE ACCURRIC HEARD NOTICE OF THE ACCURRIC HEARD NOTICE OF THE ACCURRICANCE OF THE	THESE EXECTION PLANS AND IVE PROTOGRAPHS ARE A REPRESENT EXISTING CONDITIONS OF THE BRILDING, THESE DRAWNGSHIPS EXPLANCED THE CONTROL CHARACTERISTICS OF THE EXISTING CONDITIONS. EXPLAINTLY INVESTIGATION INTO ACTUAL HIDDOS CONDITIONS. EXPLAINTLY INVESTIGATION INTO ACTUAL HIDDOS CONDITIONS. THE CONTROL OF THE ACCURACY THE GENERAL OWNFACTOR SHALL EXAMINE THESE CONDITIONS AND INCIDITY THE ARCEFIETCE OF ANY DISCREPT HIS OWNFACTOR. THE CONTROL OWNFACTOR SHALL EXPLAINS AND DISCREPT HE ARCEFIETCE OF ANY DISCREPT HIS OWNFACTOR. THE CONTROL OF THE CONTROL OWNFACTOR HIS OWNFACTOR OF THE SHALL HAVE AND THE CONTROL OWNFACTOR OWNFACTOR OWNFACTOR HIS OWNFACTOR OW	
EXISTING CONDITIONS OF THE BILLIDING. THISE DRAWNINGSPHOTOCIALS THE GASHERAL CHARACTERISTICS OF THE EXISTING CONDITIONS AND NO THE CHARACTERISTICS OF THE EXISTING CONDITIONS AND NO THE CHARACTER OF THE CHARACTE	ENSTRUC CONDITIONS OF THE BUILDING. THESE DRAWNOSSING IN GENERAL CHARACTERS IN SO THE ENSTRUGY CONDITIONS. THE GENERAL CHARACTERS IN SERVING THE ENSTRUGY CONDITIONS. THE ACCURITCE THE WORK TO BE PREFORMED BY THE OFFICE ACCURATE THE ACCURITCE THE WORK TO BE PREFORMED BY THE CHARACTER C	STATIO OTOGRA AND N S. THIS ENERAL
ENSITING CONDITIONS OF THE BULLION. THESE DRAWNINGSPHOTOGRAM THE GUISRACL AUGMAN THE SINTING CONDITIONS AND NO FOR COORDINATION OF THE WORK TO BE PERFORMED BY THE GUISRACL FOR COORDINATION OF THE WORK TO BE PERFORMED BY THE GUISRACL CONSTRUCTION AND BECOME FAMILIAR WITH THE WORK. AFTER EXAM SENTING CONDITIONS, THE GUISRACL CONTRACTOR SHALL VERIEV ALL EXISTING CONDITIONS, THE GUISRACL CONTRACTOR SHALL VERIEV ALL EXISTING CONDITIONS, THE GUISRACL CONTRACTOR SHALL VERIEV ALL EXISTING CONDITIONS AND THE NEW PROPOSED WORK. ALL WORK CON- PLANS AND DIMENSIONS BHALL BE REPLACED BY THE GENERAL CONTRA SSUEES / REVISIONS Date Description 12 APR 17 BBAC REVIEW © FRANK SHIRLEY ARCHITECTS, 2017. All rights Frank SHIRLEY ARCHITECTS, 2017. All rights	ENSTRUC CONDITIONS OF THE BUILDING. THESE DRAWNOSSING IN GENERAL CHARACTERS IN SO THE ENSTRUGY CONDITIONS. THE GENERAL CHARACTERS IN SERVING THE ENSTRUGY CONDITIONS. THE ACCURITCE THE WORK TO BE PREFORMED BY THE OFFICE ACCURATE THE ACCURITCE THE WORK TO BE PREFORMED BY THE CHARACTER C	ITATIO OTOGRA AND N S. THIS ENERAL
ENSITING CONDITIONS OF THE BULLION. THESE DRAWNINGSPHOTOGRAM THE GUISRACL AUGMAN THE SINTING CONDITIONS AND NO FOR COORDINATION OF THE WORK TO BE PERFORMED BY THE GUISRACL FOR COORDINATION OF THE WORK TO BE PERFORMED BY THE GUISRACL CONSTRUCTION AND BECOME FAMILIAR WITH THE WORK. AFTER EXAM SENTING CONDITIONS, THE GUISRACL CONTRACTOR SHALL VERIEV ALL EXISTING CONDITIONS, THE GUISRACL CONTRACTOR SHALL VERIEV ALL EXISTING CONDITIONS, THE GUISRACL CONTRACTOR SHALL VERIEV ALL EXISTING CONDITIONS AND THE NEW PROPOSED WORK. ALL WORK CON- PLANS AND DIMENSIONS BHALL BE REPLACED BY THE GENERAL CONTRA SSUEES / REVISIONS Date Description 12 APR 17 BBAC REVIEW © FRANK SHIRLEY ARCHITECTS, 2017. All rights Frank SHIRLEY ARCHITECTS, 2017. All rights	ENSTRUC CONDITIONS OF THE BUILDING. THESE DRAWNOSSING IN GENERAL CHARACTERS IN SO THE ENSTRUGY CONDITIONS. THE GENERAL CHARACTERS IN SERVING THE ENSTRUGY CONDITIONS. THE ACCURITCE THE WORK TO BE PREFORMED BY THE OFFICE ACCURATE THE ACCURITCE THE WORK TO BE PREFORMED BY THE CHARACTER C	TATIO DTOGRA AND N S. THIS ENERAL
EMSTRUCCONDITIONS, THE GUSTREAL CONTRACTOR SHALL VIEHE VALLAD DIMENSIONS AND NOTHY THE ACHIFFET OF ANY DESCRIPTANCES EXISTING CONDITIONS AND THE SASE PROPOSED WORK. ALL WORK CONFEDENCE OF THE CONTRACTOR OF THE	EXISTING CONDITIONS, THE GIABRAL CONTRACTOR SHALL YES AND DIBINGHOUS AND OUTHY THE ACRITICATOR SHALL YES EXISTING CONDITIONS AND DIBINGHOUS AND OUTHY THE ACRITICATOR OF THE ACRITICATOR OF THE ACRITICATOR OF THE ACRITICATOR BY THE GIRBLACTOR OF THE ACRITICATOR BY THE GIRBLACTOR OF THE ACRITICATOR O	S. THIS
EMSTRUCCONDITIONS, THE GUSTREAL CONTRACTOR SHALL VIEHE VALLAD DIMENSIONS AND NOTHY THE ACHIFFET OF ANY DESCRIPTANCES EXISTING CONDITIONS AND THE SASE PROPOSED WORK. ALL WORK CONFEDENCE OF THE CONTRACTOR OF THE	EXISTING CONDITIONS, THE GIABRAL CONTRACTOR SHALL YES AND DIBINGHOUS AND OUTHY THE ACRITICATOR SHALL YES EXISTING CONDITIONS AND DIBINGHOUS AND OUTHY THE ACRITICATOR OF THE ACRITICATOR OF THE ACRITICATOR OF THE ACRITICATOR BY THE GIRBLACTOR OF THE ACRITICATOR BY THE GIRBLACTOR OF THE ACRITICATOR O	S IN TH
ISSUES / REVISIONS Date Description 12 APR 17 BBAC REVIEW OF FRANK SHIRLEY ARCHITECTS, 2017. All rights	ISSUES / REVISIONS Date Description 12 APR 17 BBAC REVIEW OF FRANK SHIRLEY ARCHITECTS, 2017. All	R EXAM IFY ALI ANCIES IRK COL IGN OR
Date Description 12 APR 17 BBAC REVIEW OFRANK SHIRLEY ARCHITECTS, 2017. All rights	Date Description 12 APR 17 BBAC REVIEW BBAC REVIEW FRANK SHIRLEY ARCHITECTS, 2017. All	CONTE
© FRANK SHIRLEY ARCHITECTS, 2017. All rights	12 APR 17 BBAC REVIEW © FRANK SHIRLEY ARCHITECTS, 2017. All	
© FRANK SHIRLEY ARCHITECTS, 2017. All right	© FRANK SHIRLEY ARCHITECTS, 2017. All	
This drawing cannot be reproduced without perm	This drawing cannot be reproduced without	righ
		t per
	DRAWING TITLE	
DRAWING TITLE	Preceden	t I
DRAWING TITLE Precedent P	SCALE	
Precedent P	DATE	
Precedent P	Apri	

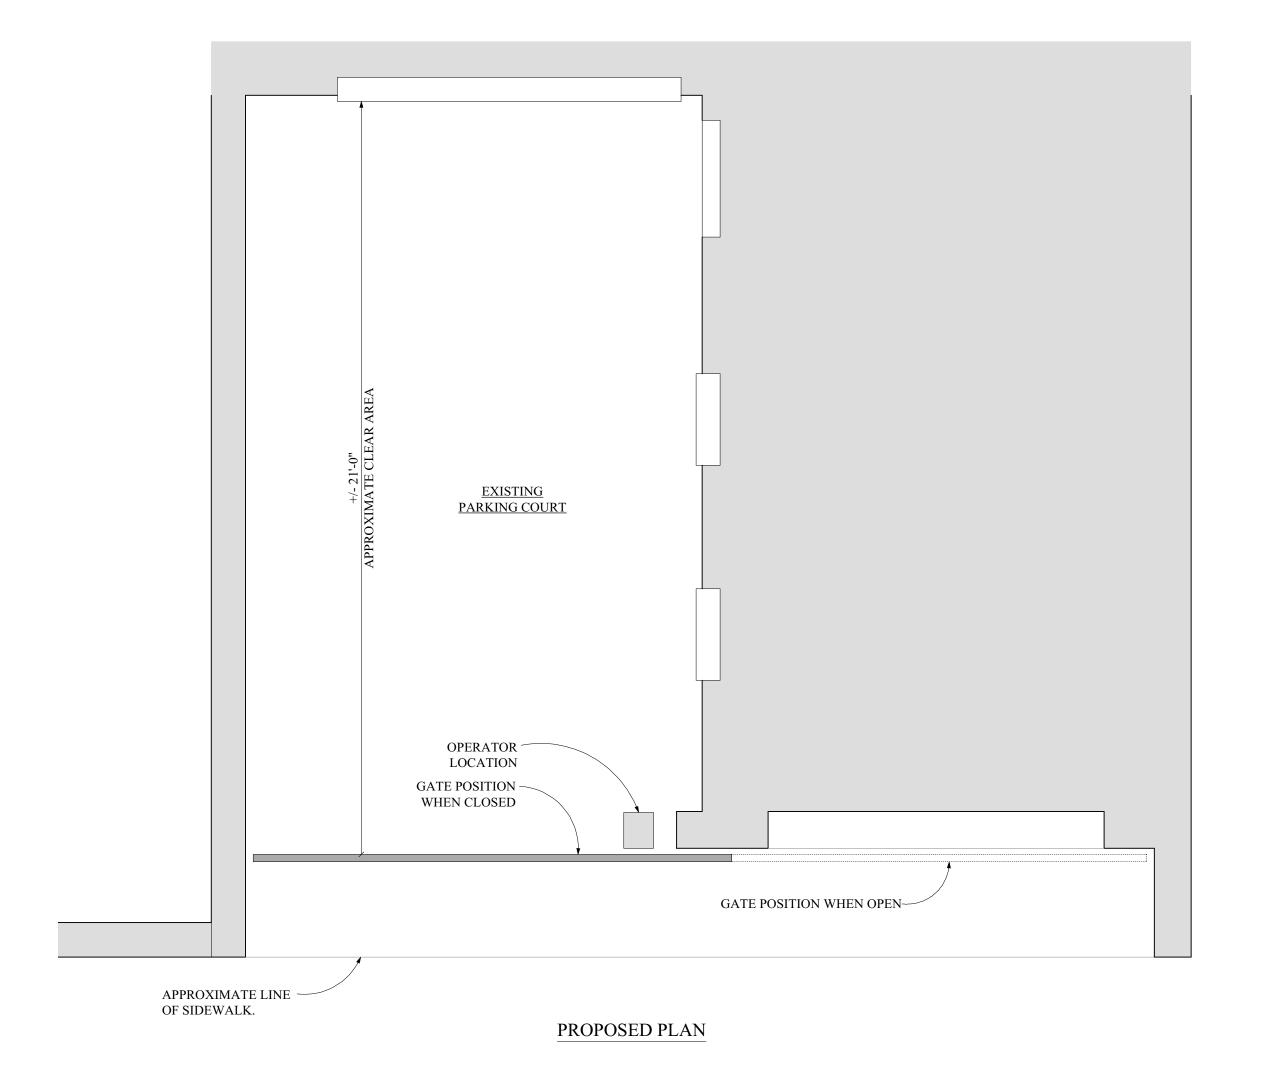

FRANK SHIRLEY

ARCHITECTS

40 Pearl Street t: 617.547.3355 Cambridge MA 02139 f: 617.547.2385

www.frankshirleyarchitects.com

PROJECT

Alterations to:

55 COMMONWEALTH AVE. Boston, MA 02116

THESE EXISTING FLANS ANDOR PROTOGRAPHS ARE A REPRESENTATION OF THE
EXISTING COSDITIONS OF THE BULLSTON, THESE DRAWNING-PROTOGRAPHS ARE FOR
THE GENERAL CHARACTERISTICS OF THE EXISTING CONDITIONS. THIS DYDING AND TAY
EXPLANSIVE THE WITHOUT STREET AND THE EXISTING CONDITIONS. THIS DYDING AND
THE AGENT THE BURS ON RESPONSIBILITY FOR THE ACCURACY OF THE PROMOMENT
THE AGENT THE BURS ON RESPONSIBILITY FOR THE ACCURACY OF THE INFORMATION
THE GENERAL CONTRACTOR SHALL EXAMINE THESE CONDITIONS IN THE FIELD PRIOR TO CONSTRUCTION AND RECORD FAMILIAR WITH THE WORK. AFTER EXAMINATION OF THE
EXISTING CONDITIONS. THE GENERAL CONTRACTOR SHALL VERY ALL CONDITIONS
THE ACCURACY OF THE THE PROPERTY OF THE PROPERTY

ISSUES / REVISIONS

Date Description
12 APR 17 BBAC REVIEW

ZAIKI/ BBACKEVI

© FRANK SHIRLEY ARCHITECTS, 2017. All rights reserved.
This drawing cannot be reproduced without permission.

DRAWING TITLE


Proposed Plan

SCALE

DATE

April 12, 2017

SHEET NUMBER

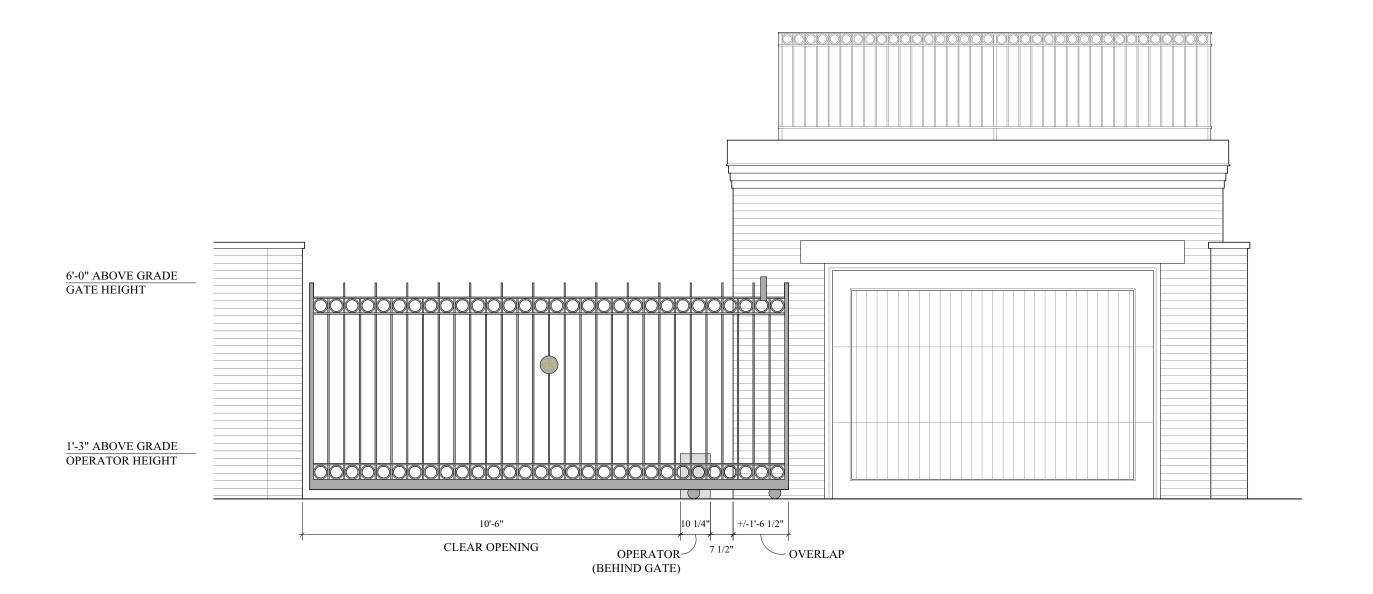

PROPOSED ELEVATION

FRANK SHIRLEY

ARCHITECTS

40 Pearl Street t: 617.547.3355 Cambridge MA 02139 f: 617.547.2385

www.frankshirleyarchitects.com

PROJECT

Alterations to:

55 COMMONWEALTH AVE. Boston, MA 02116

THISSE EXISTING PLANS ARROW REFORGABIS ARE A REPRESENTATION OF THE EXISTING CONDITIONS OF THE BILLION. THISSE DAMAINOS PHOTOGRAPHS ARE FOR THIS GENERAL CHARACTERISTICS OF THE EXISTING CONDITIONS AND NOT AN EXAMINATION PROVIDED THE WINTERGATION FOR ACTUAL HIRDDON CONDITIONS. THIS INTORMATE FOR CONDITIONS THE WINTERGATE OF THE WINTERGAT CONDITIONS OF THE WINTERGAT CONDITIONS OF THE WINTERGAT CONTRACTOR SHALL EXAMINE THISSE CONDITIONS OF THE NORMAN HIR GENERAL CONTRACTOR SHALL EXAMINE THISSE CONDITIONS OF THE WINTERGAT CONTRACTOR SHALL EXAMINE THISSE CONDITIONS OF THE WINTERGAT CONTRACTOR SHALL EXAMINE THISSE CONTRACTOR SHALL EXAMINE THIS CONTRACTOR SHALL EXAMINE THIS CONDITIONS OF THE WINTERGAT CONTRACTOR SHALL EXAMINE THIS CONDITIONS. THE GENERAL CONTRACTOR SHALL EXAMINE THIS CONTRACTOR SHALL EXAMINE THE WINTERGAT CONTRACTOR SHALL PROPERTY AND CONTRACTOR SHALL PROPERT

ISSUES / REVISIONS

Date Description
12 APR 17 BBAC REVIEW

Z APK I/ BBAC KEVI

© FRANK SHIRLEY ARCHITECTS, 2017. All rights reserved.
This drawing cannot be reproduced without permission.

DRAWING TITLE

Proposed Elevation


SCALE

DATE

April 12, 2017

SHEET NUMBER



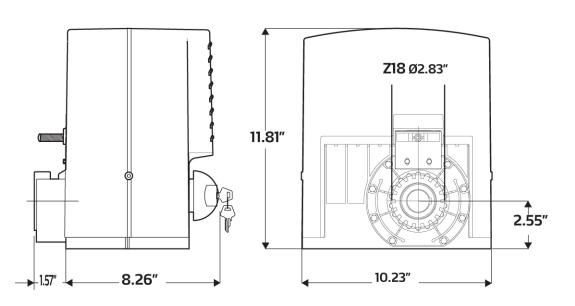

PROPOSED GATE OPERATOR

F R A	NK SHIRLEY
A R	C H I T E C T S
-	reet t: 617.547.335 MA 02139 f: 617.547.238 ankshirleyarchitects.com
PROJECT	
	Alterations to:
55 (COMMONWEALTH AVE. Boston, MA 02116
EXISTING CONDITION THE GENERAL CHA EXHAUSTIVE INVESTOR COORDINATION THE ARCHITECT BE	LANS AND/OR PROTOGRAPHS ARE A REPRESENTATION OF THE UNSO OF THE BUILDING. THESE DRAWNINGS PHOTOGRAPHS ARE FOR BACKTERISTICS OF THE EXISTING COMBITIONS AND NOT AN STORATION NOTO ACTUAL HIRDING CONDITIONS. AND NOT AN STORATION NOTO ACTUAL HIRDING CONDITIONS AND NOTA STORATION NOTO ACTUAL HIRDING CONDITIONS IN THE NOTIONAL TO THE ACTUAL STATE OF THE STORAGE OF THE ST
ISSUES / RE	EVISIONS Description
	BBAC REVIEW

Proposed Plan

SCALE

DATE

April 12, 2017

SHEET NUMBER